
10th Street South Access Drive Neighboring Properties Parking



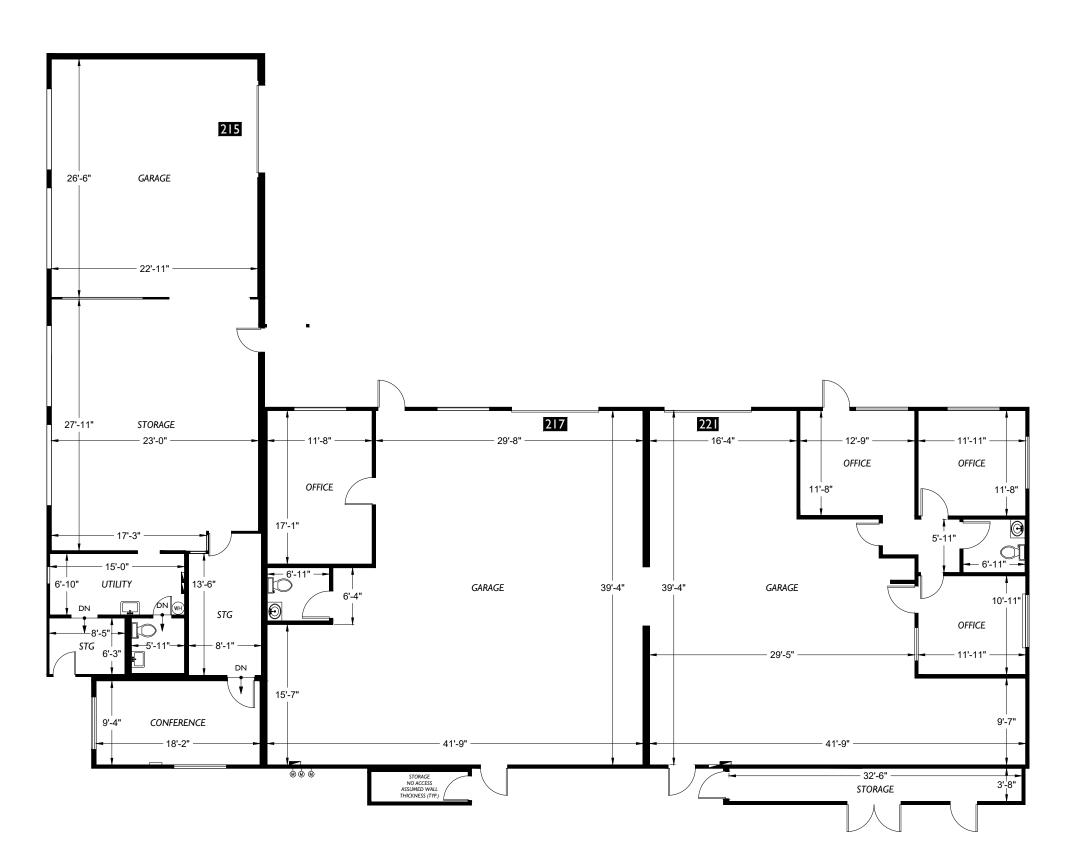

2DFLOORPLANS.COM

371 NW Gilman Blvd. Suite 140 Issaquah, WA 98027 425-677-7511

This drawing is an instrument of service and is the sole property of the client listed. Any alteration of this drawing without removal of references to 2-D As-Built Floor Plans, Inc. is prohibited.

Drawing scale and dimensions are provided for reference only. Refer to CAD files for exact measurements.

©2010 2-D As-Built Floor Plans, Inc. All Rights Reserved.

Project: 102618

75 Project | 1/3/2025 | Insal building measure | 1/3/2025 | Insal

Client: Royal Commercial

c/o Matthew Royal 611 Market Street, Suite 8 Kirkland, WA 98033

Site: Industrial Building

Industrial Building
215-221 10th Street South
Kirkland, WA 98033



Floor Plan



0 10 20 30

Scale: 3/32" = 1'-0"